



WALNUT



**Suite 130**  
5,276 RSF

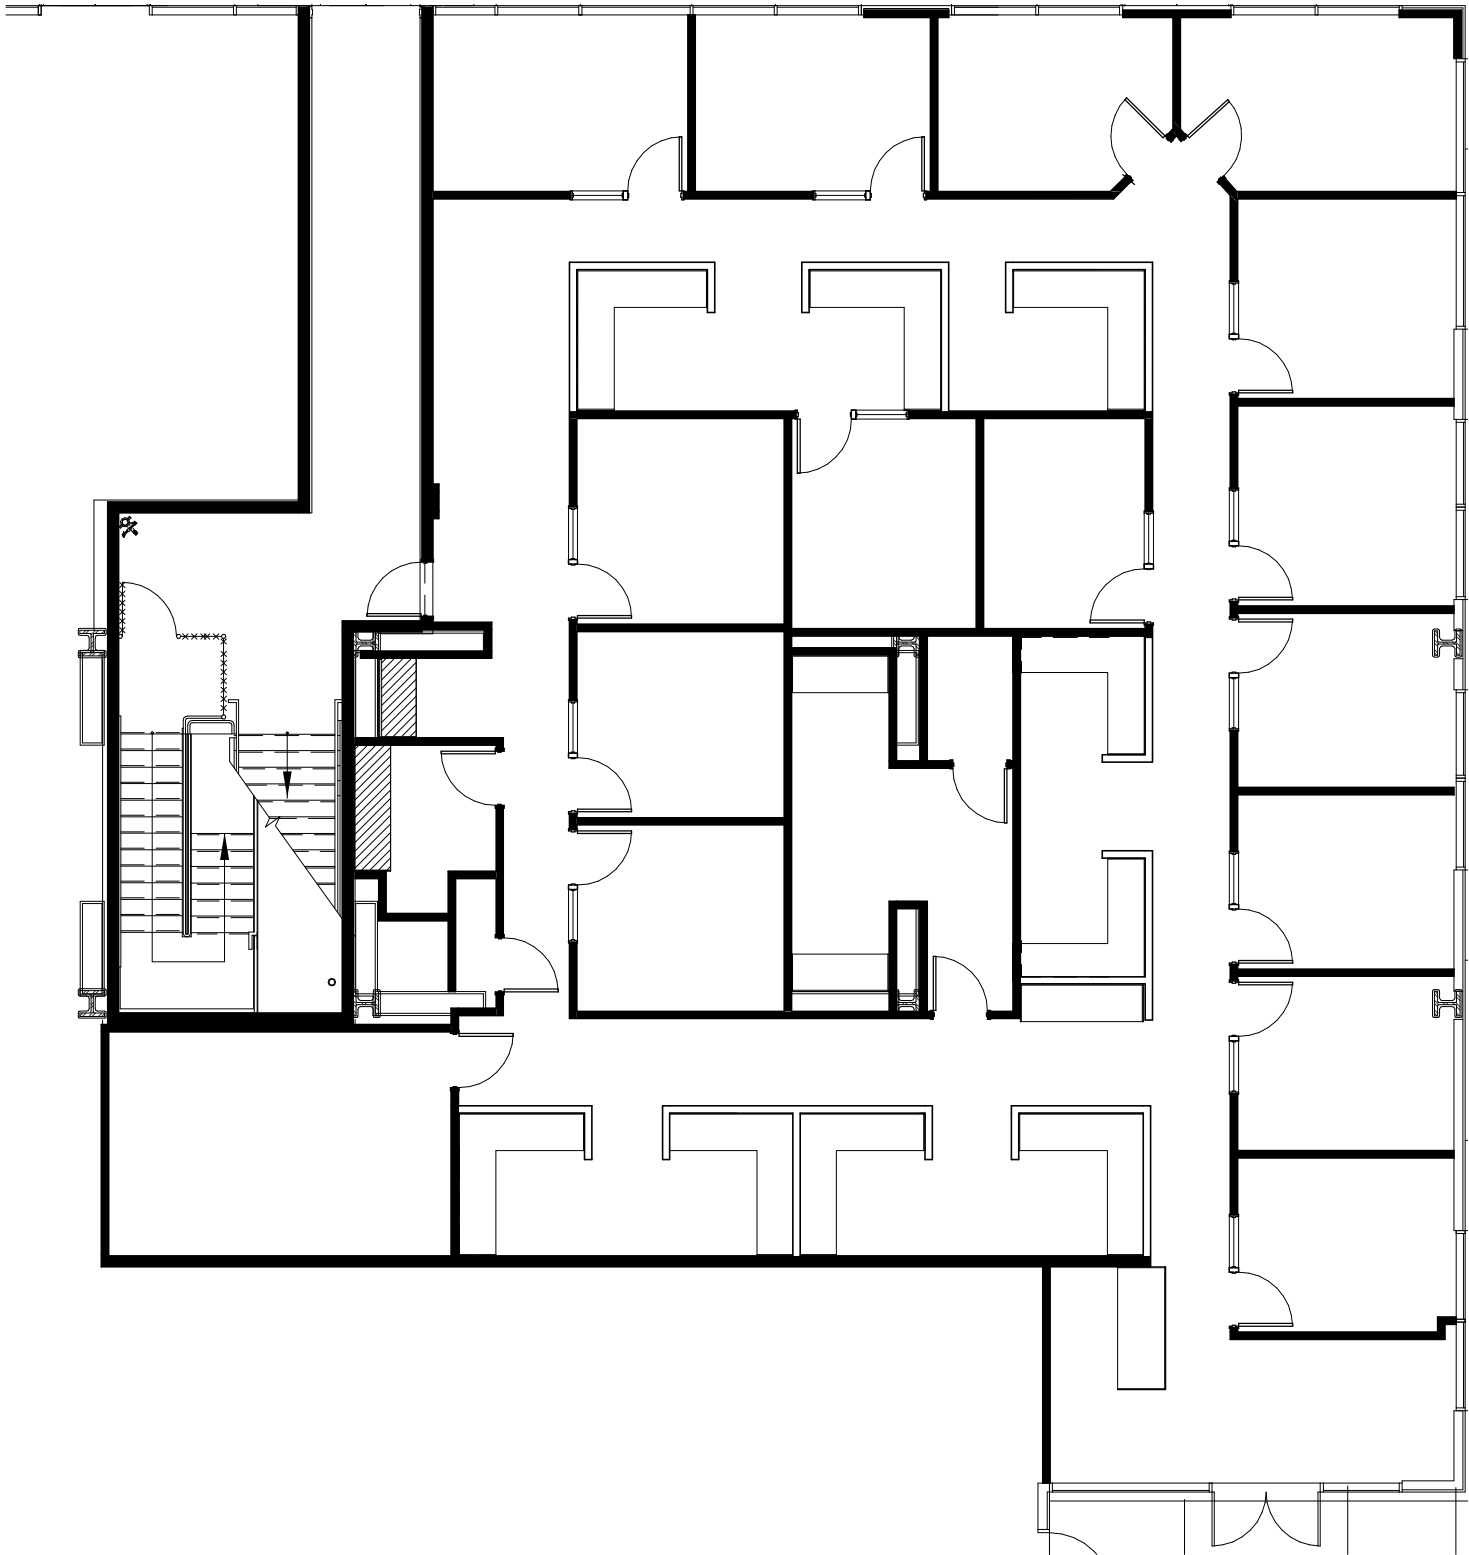


Patrick Foudy  
213.362.9313  
pfoudy@idsrealestate.com

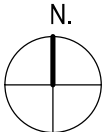

888. E. Walnut  
Pasadena, CA | 08.11.16 |




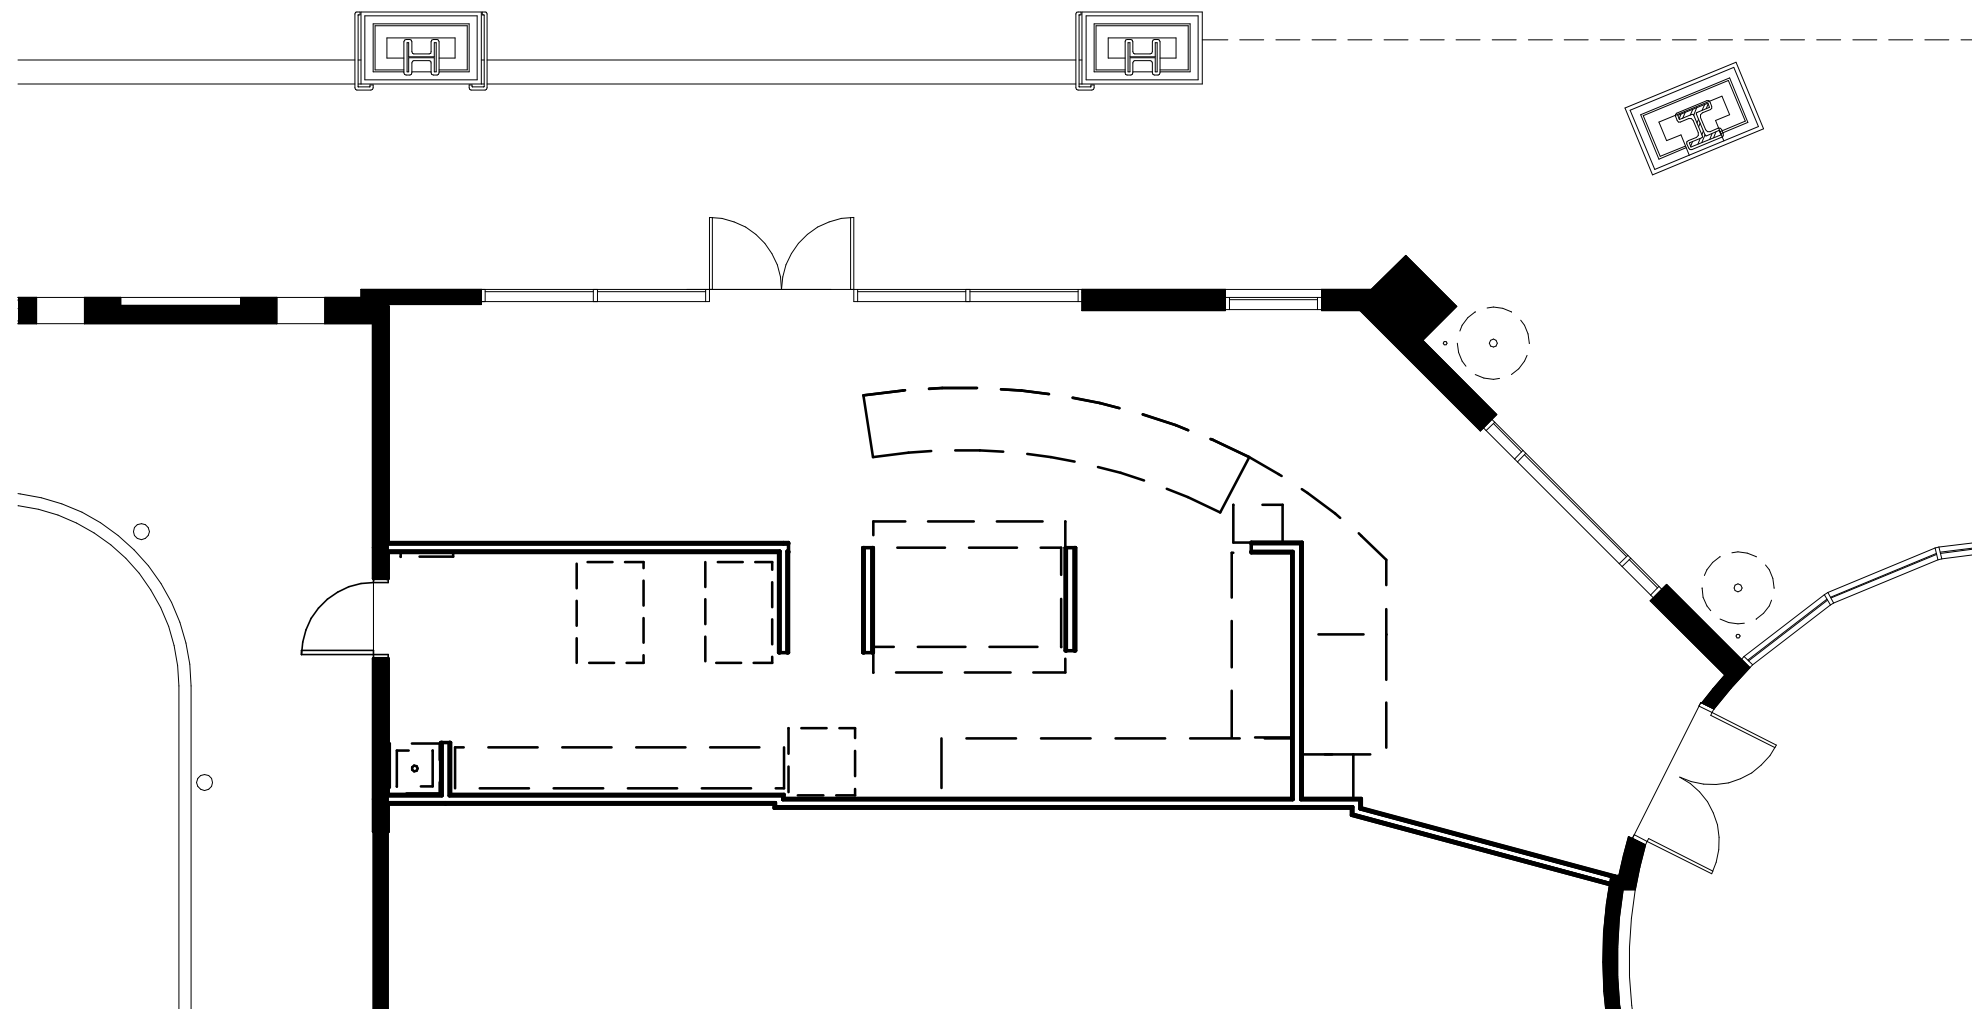

**Suite 140**  
1,162 RSF




Patrick Foudy  
213.362.9313  
pfoudy@idsrealestate.com

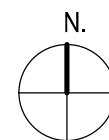

888 E. Walnut  
Pasadena, CA | 08.11.16 |



WALNUT

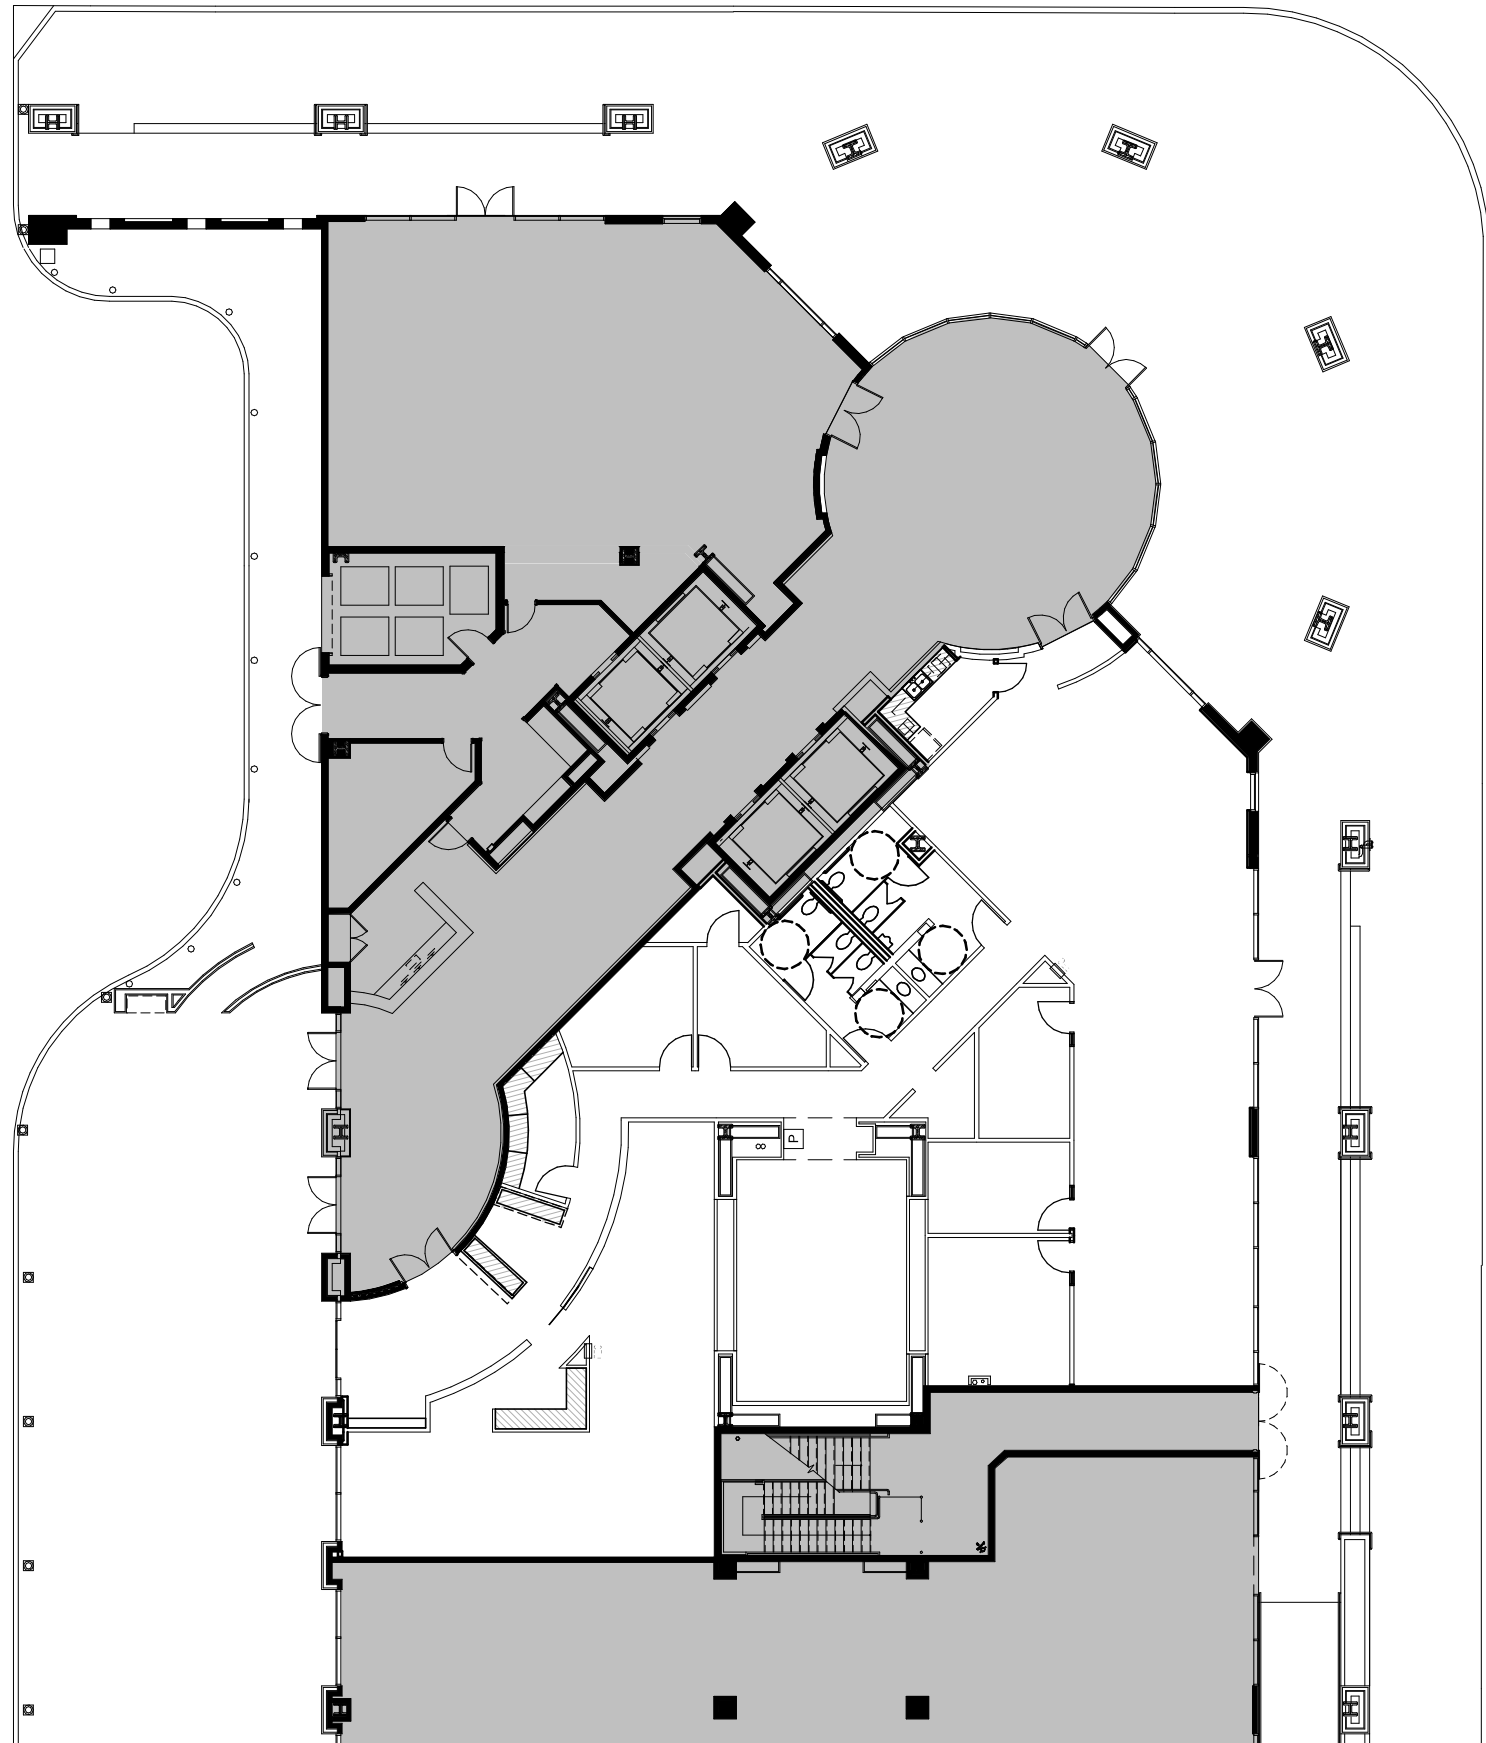


LAKE



**Suite 150**  
**6,255 RSF**




Patrick Foudy  
 213.362.9313  
 pfoudy@idsrealestate.com

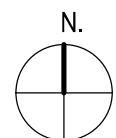

888 E. Walnut  
 Pasadena, CA | 08.11.16 |




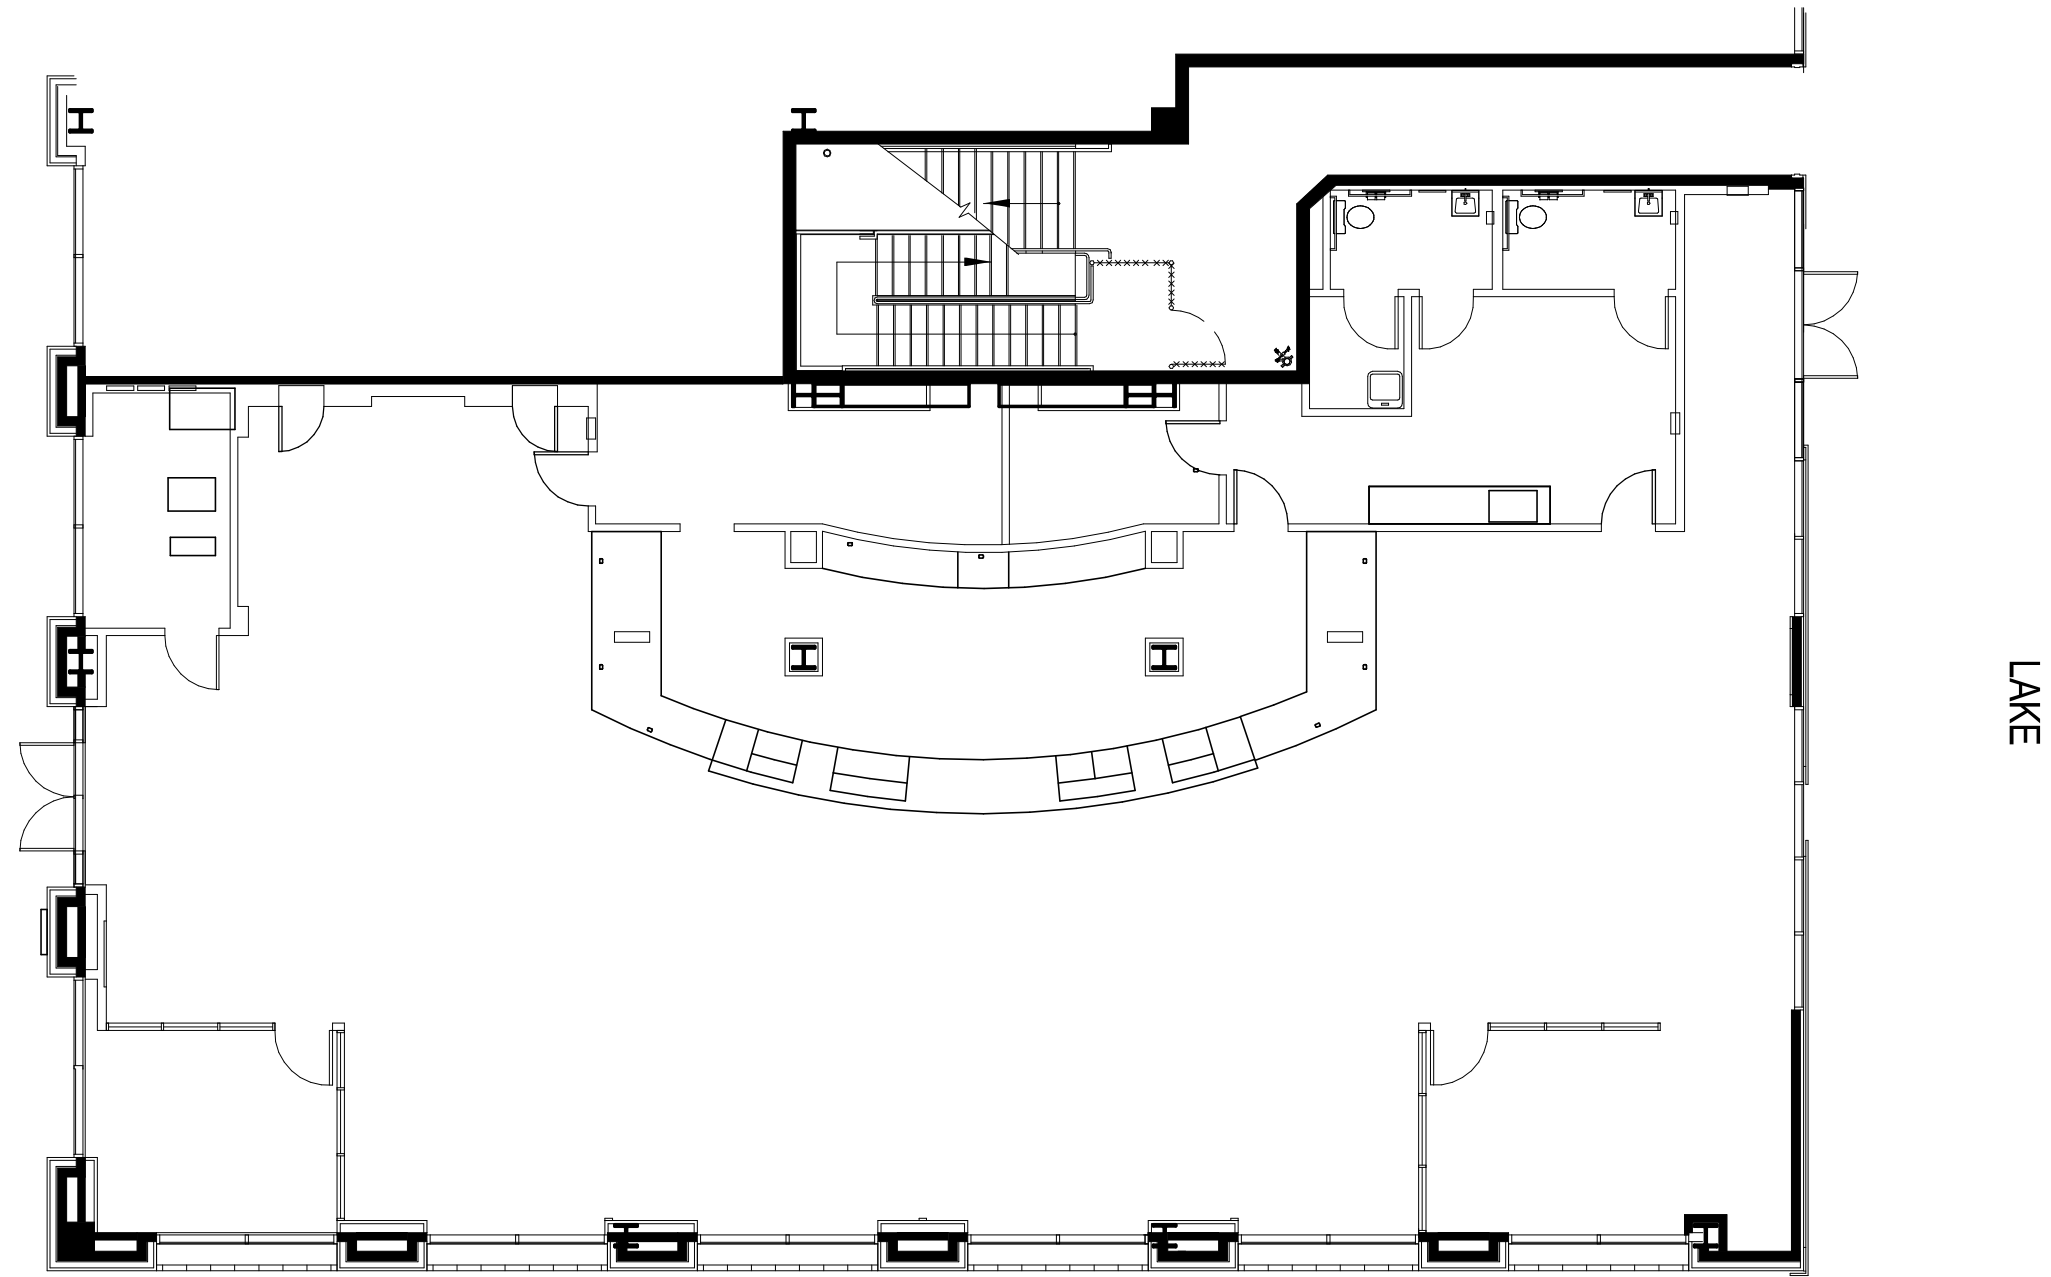

**Suite 190**  
5,420 RSF




Patrick Foudy  
213.362.9313  
pfoudy@idsrealestate.com

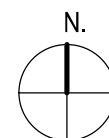

888 E. Walnut  
Pasadena, CA | 08.11.16 |



WALNUT

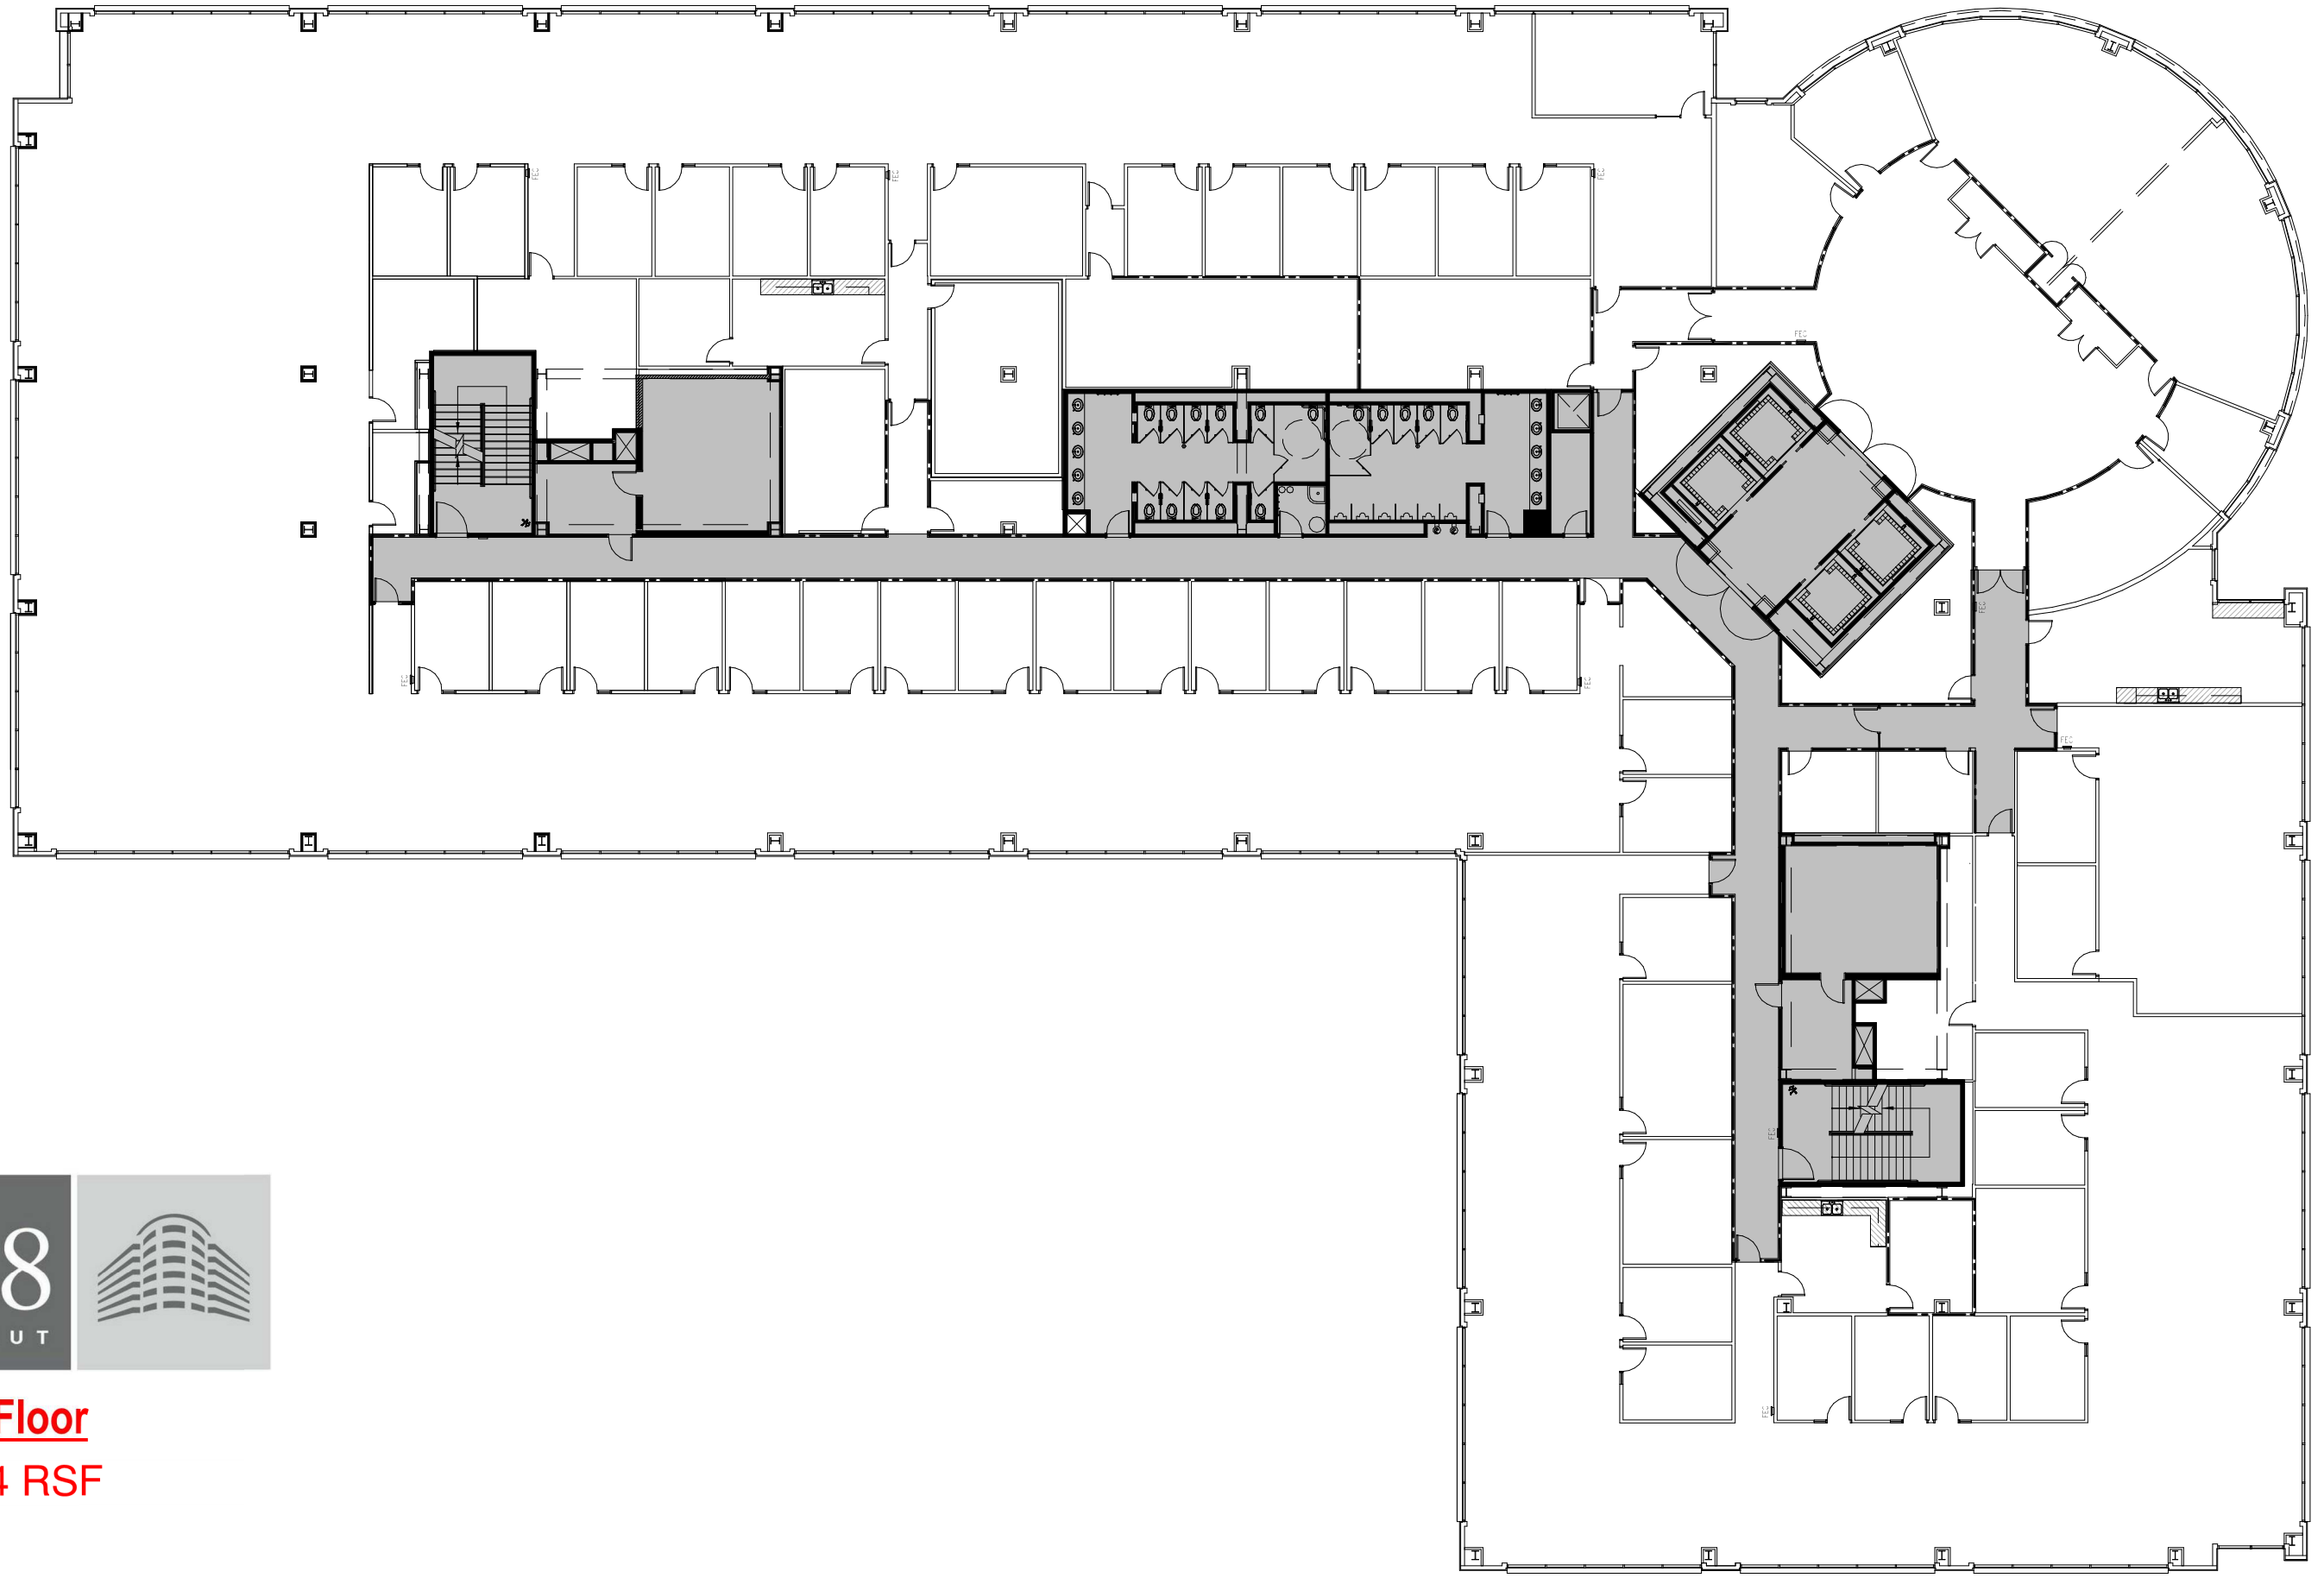


LAKE



**Third Floor**  
**42,374 RSF**




Patrick Foudy  
 213.362.9313  
 pfoudy@idsrealestate.com

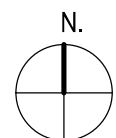





888 E. Walnut  
 Pasadena, CA | 08.11.16 |

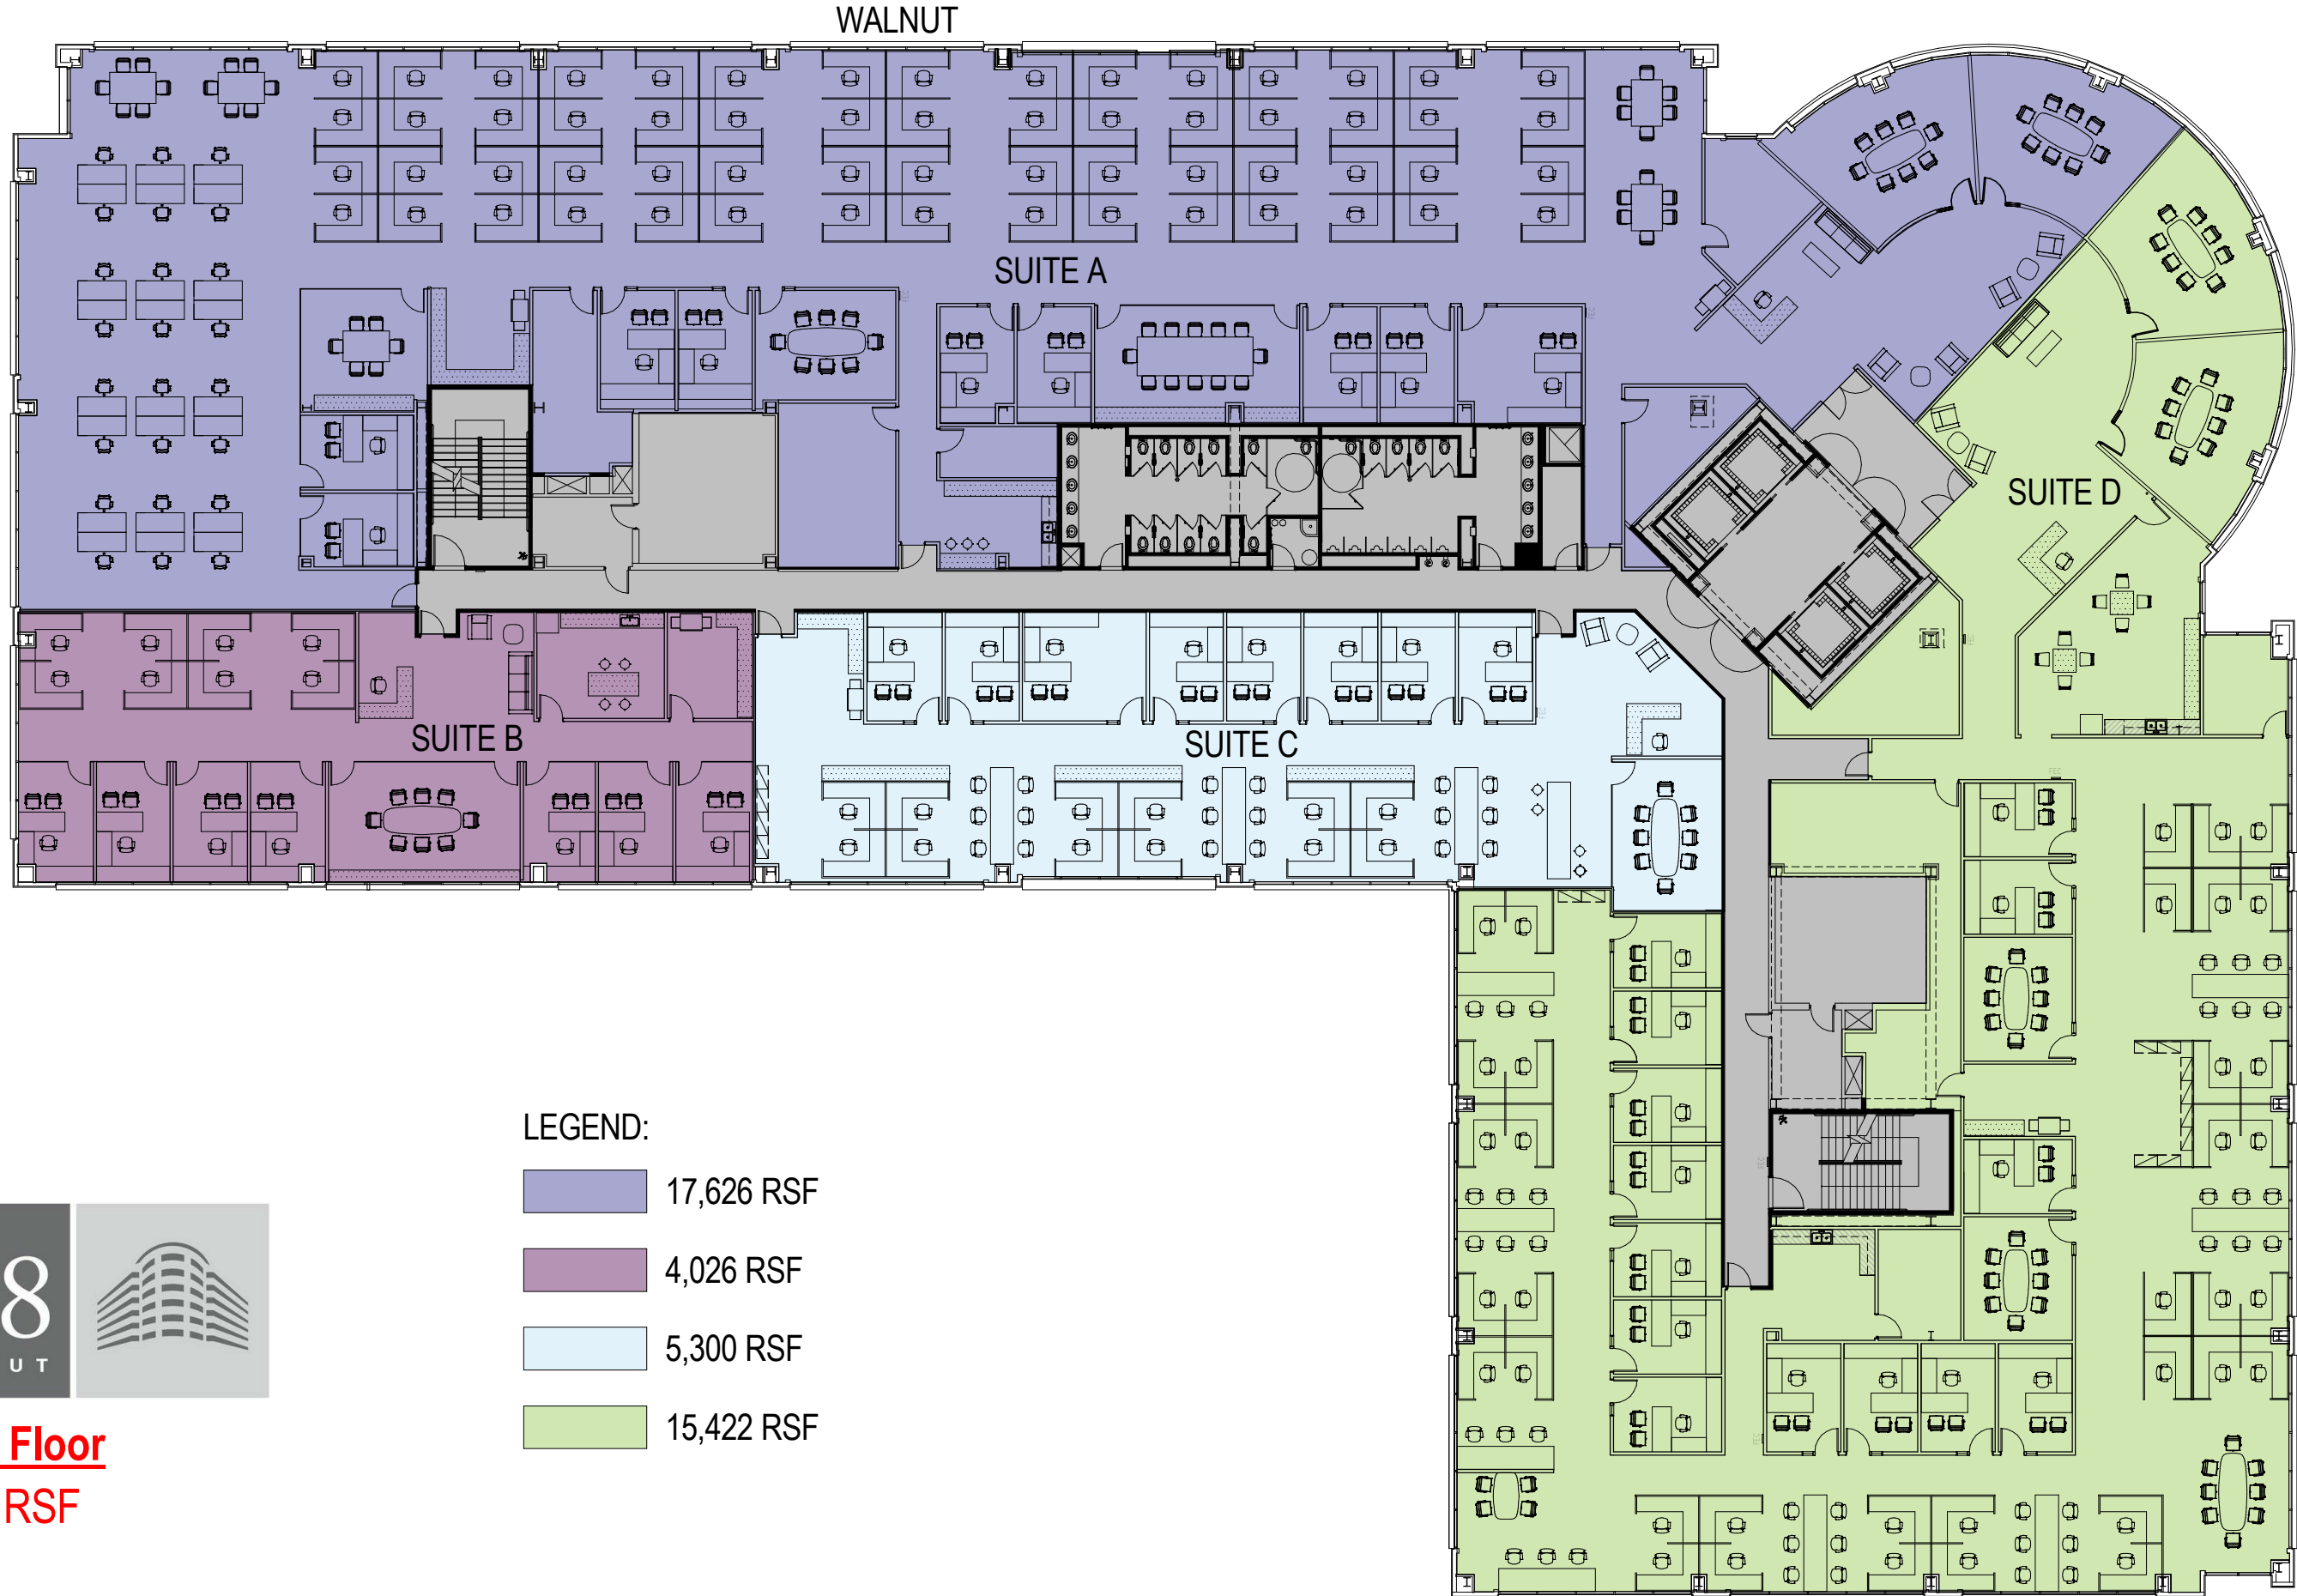



LEGEND:

 
	17,626 RSF
	4,026 RSF
	5,300 RSF
	15,422 RSF



**Fourth Floor**  
**42,374 RSF**




Patrick Foudy  
 213.362.9313  
 pfoudy@idsrealestate.com

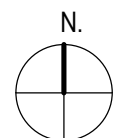

888 E. Walnut  
 Pasadena, CA | 08.11.16 |



WALNUT

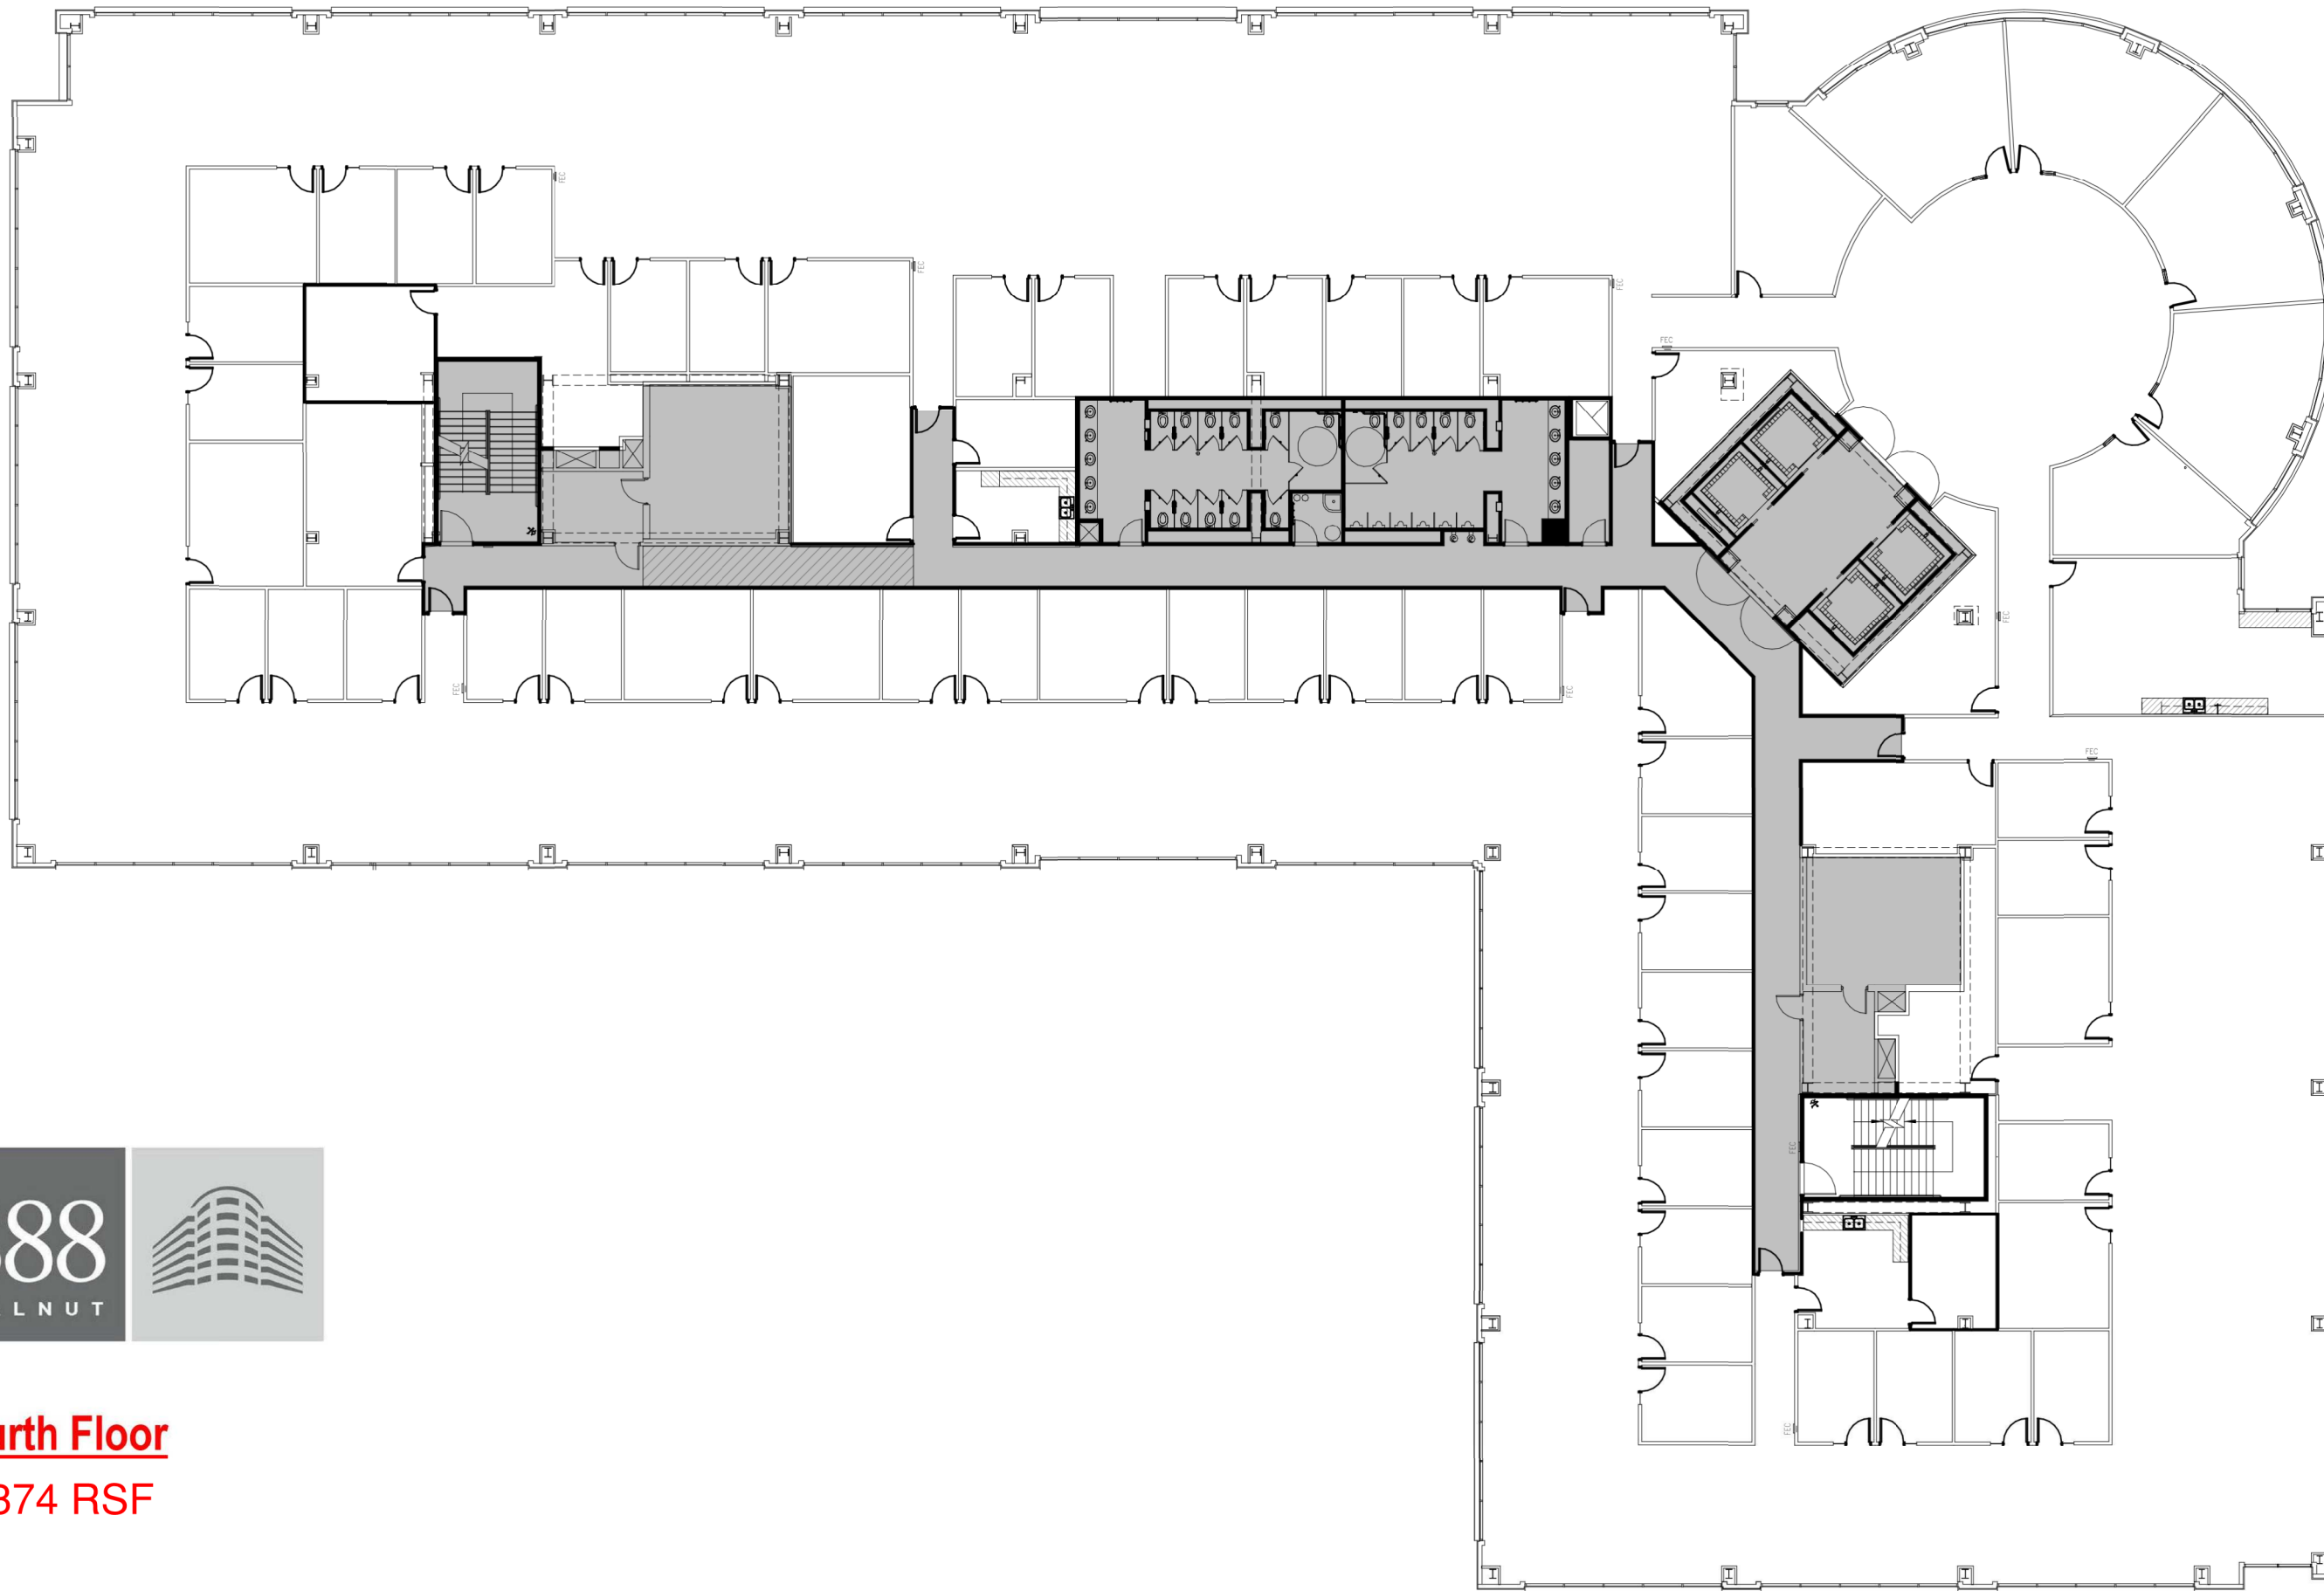

LAKE



**Fourth Floor**  
**42,374 RSF**



Patrick Foudy  
 213.362.9313  
 pfoudy@idsrealestate.com




As-Built  
 888 E. Walnut  
 Pasadena, CA | 08.11.16 |



WALNUT

LAKE

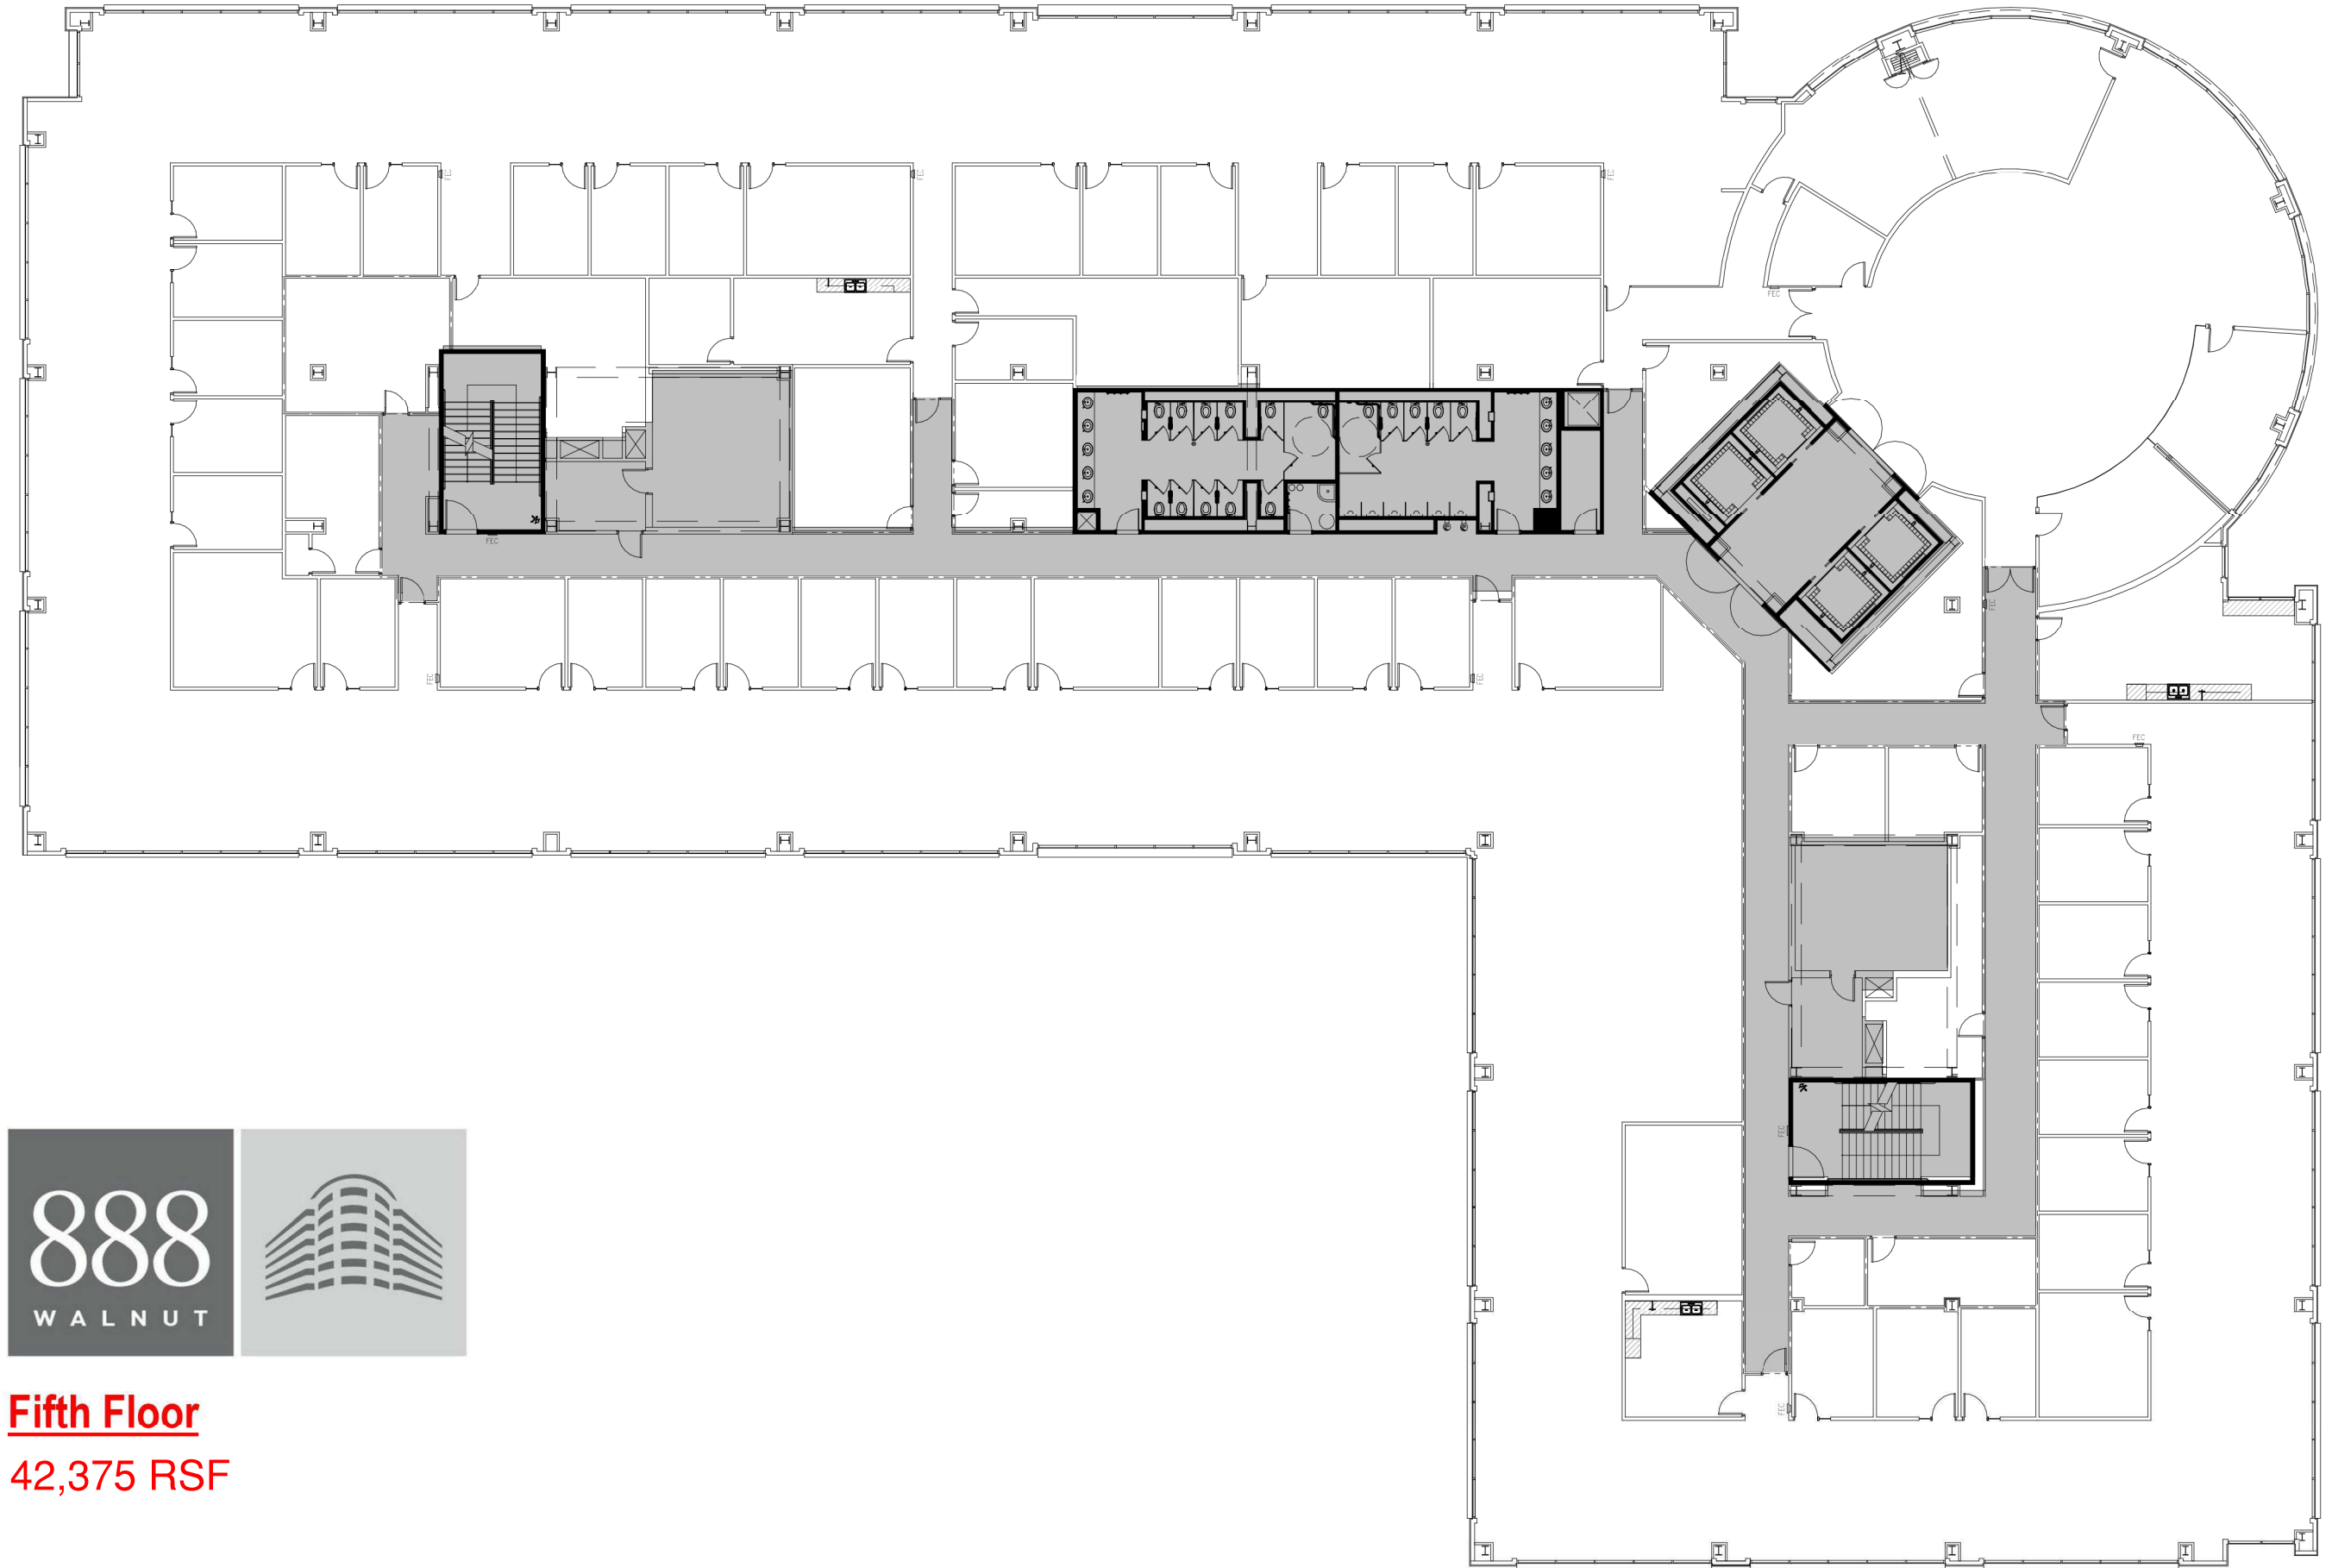


**Fifth Floor**

**42,375 RSF**



Patrick Foudy  
 213.362.9313  
 pfoudy@idsrealestate.com

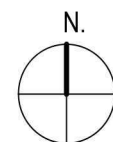


As-Built  
 888 E. Walnut  
 Pasadena, CA | 08.11.16 |





WALNUT

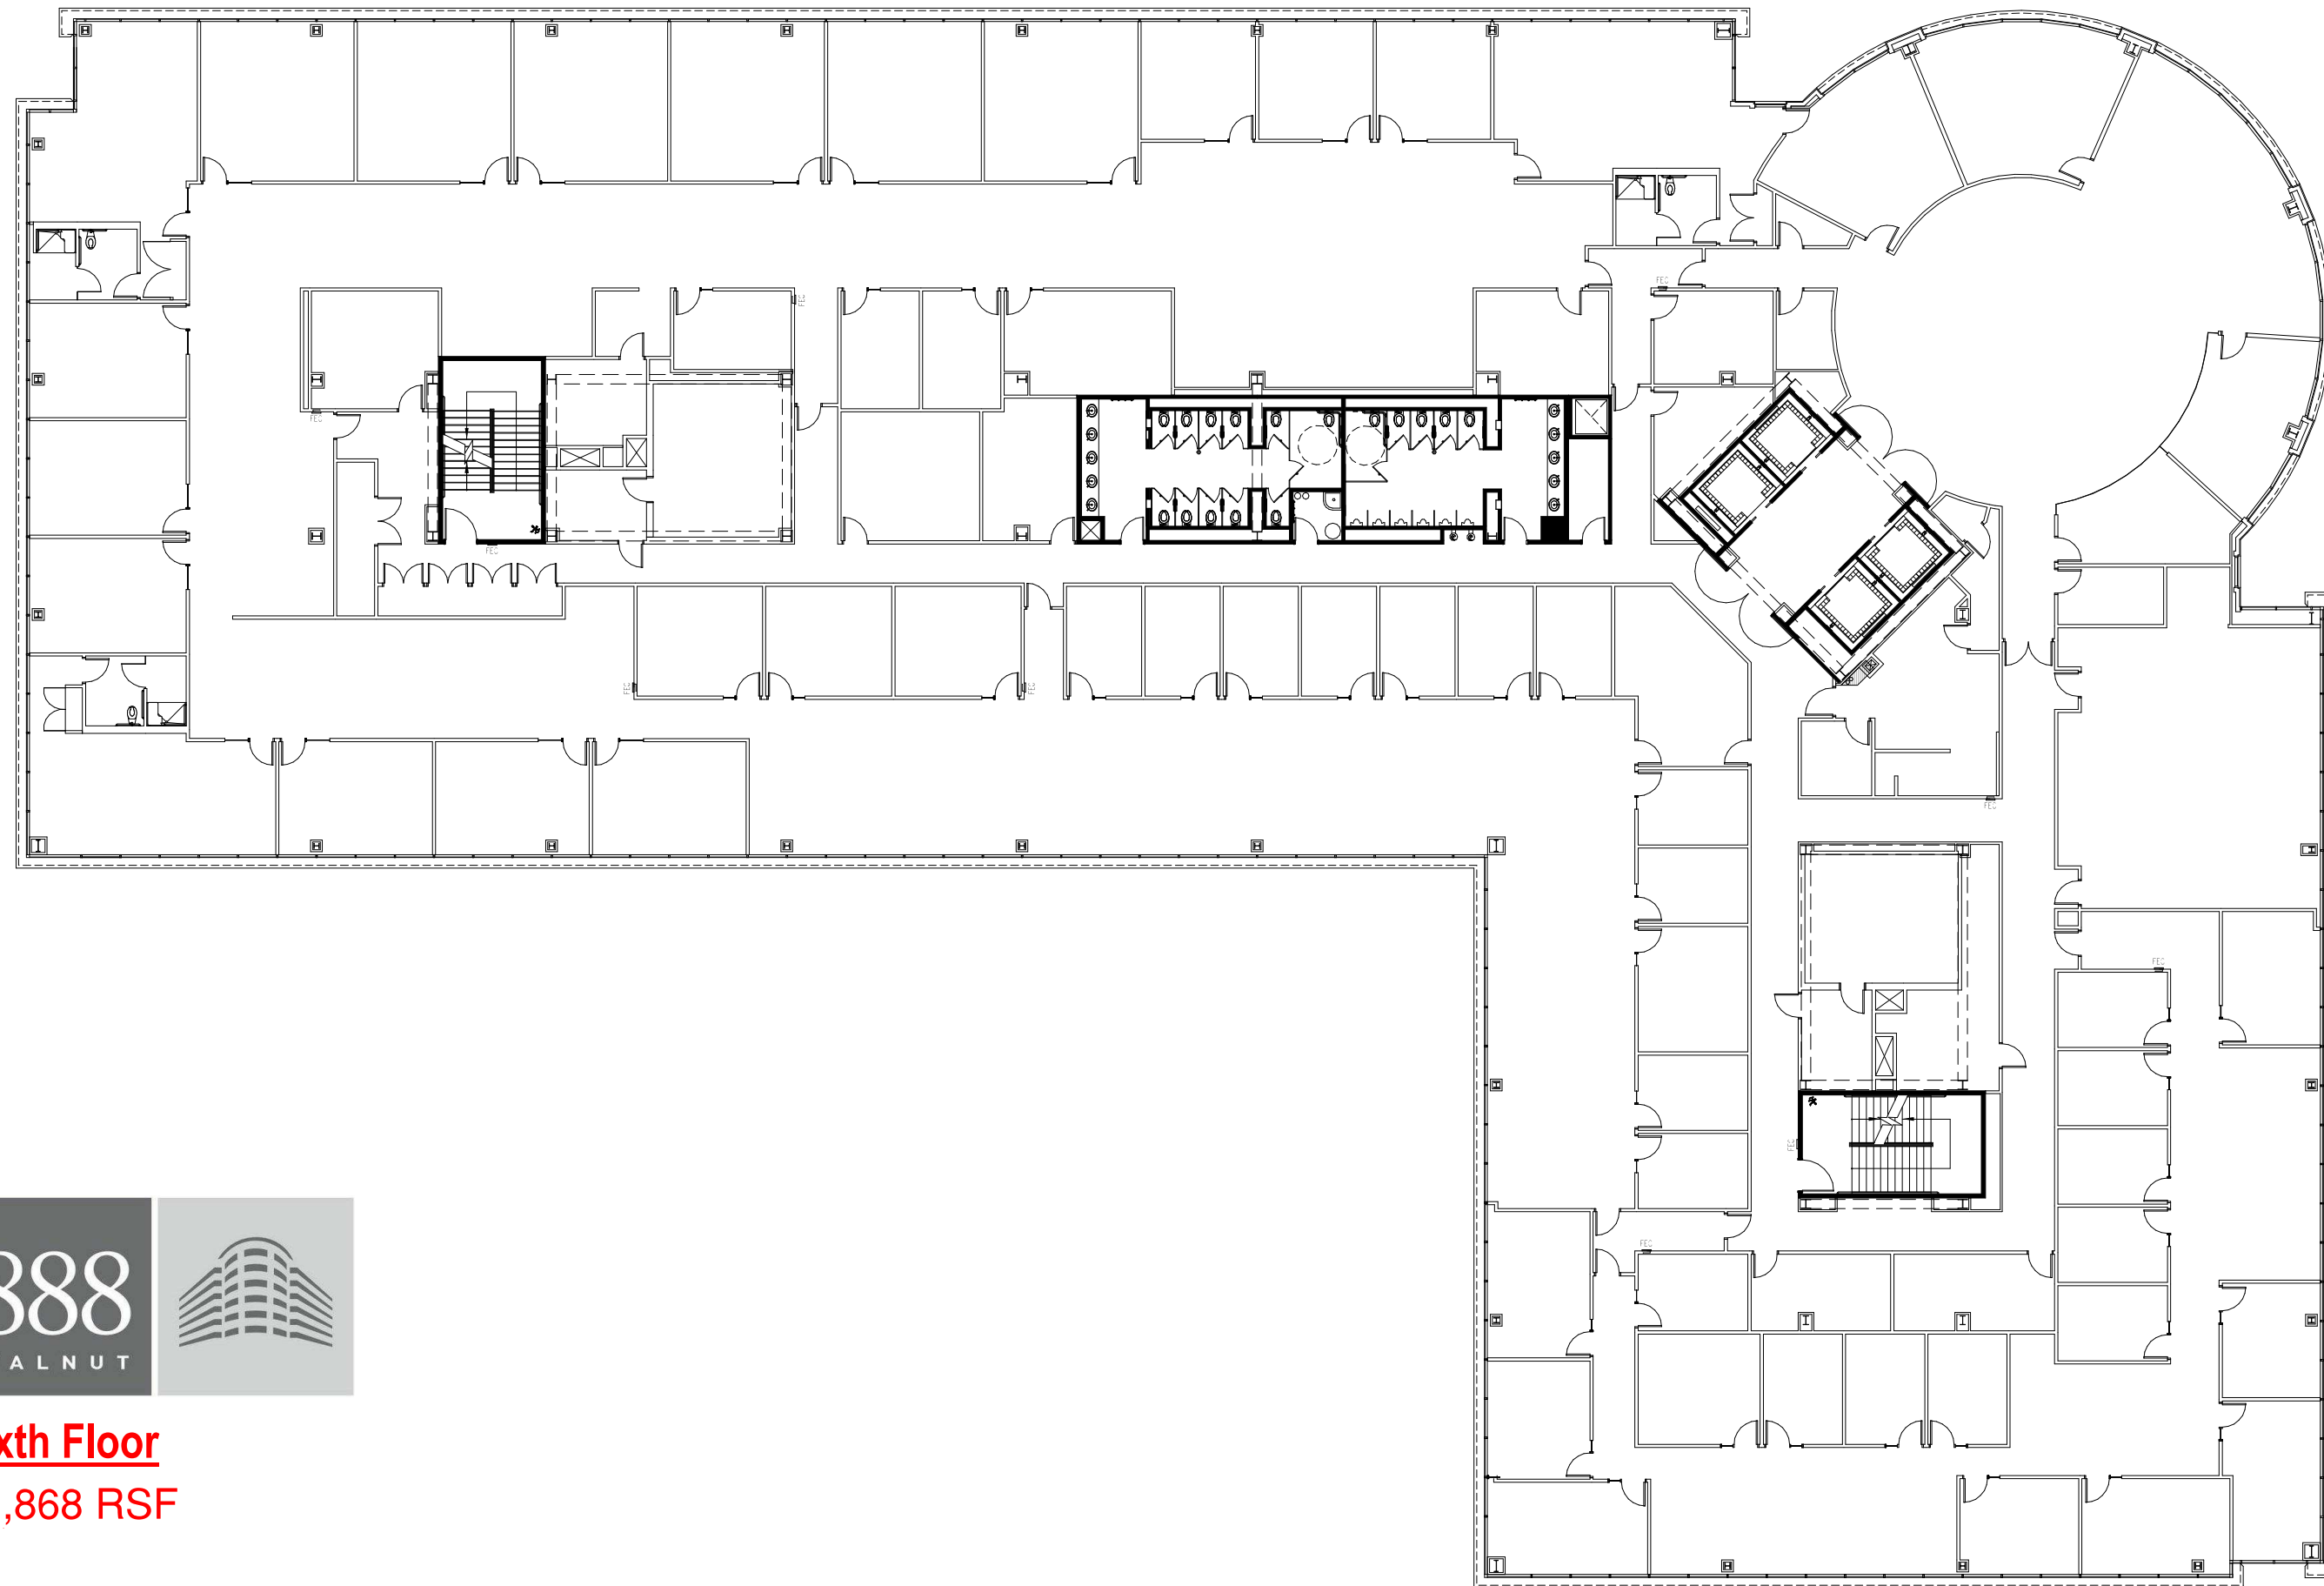


LAKE



**Sixth Floor**  
**41,868 RSF**



Patrick Foudy  
 213.362.9313  
 pfoudy@idsrealestate.com

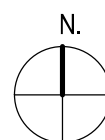

Marketing Floor Plan Study - 6th Floor  
 888 E. Walnut  
 Pasadena, CA | 08.11.16 |

